

8/12


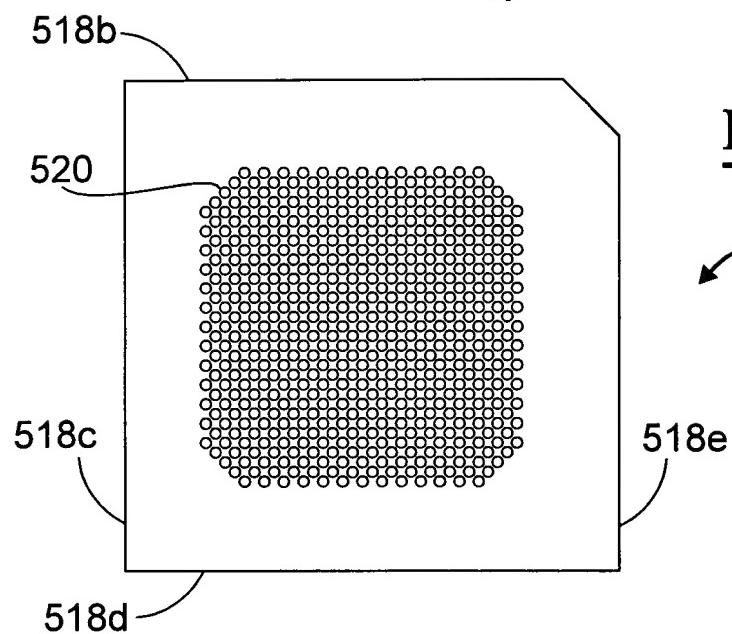


Figure 5C


518

Figure 6A

580

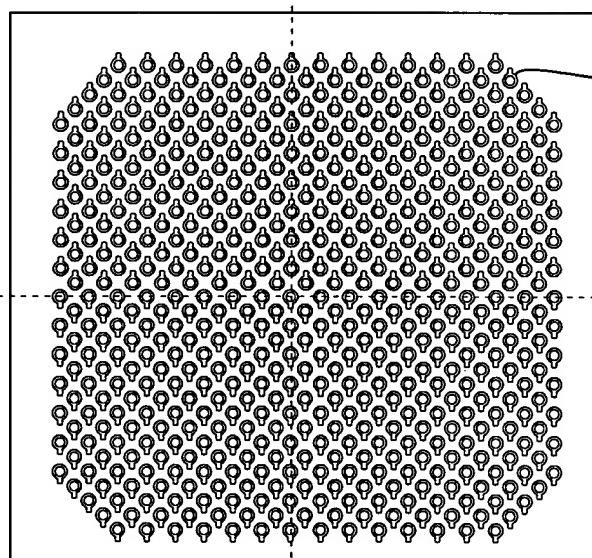

582

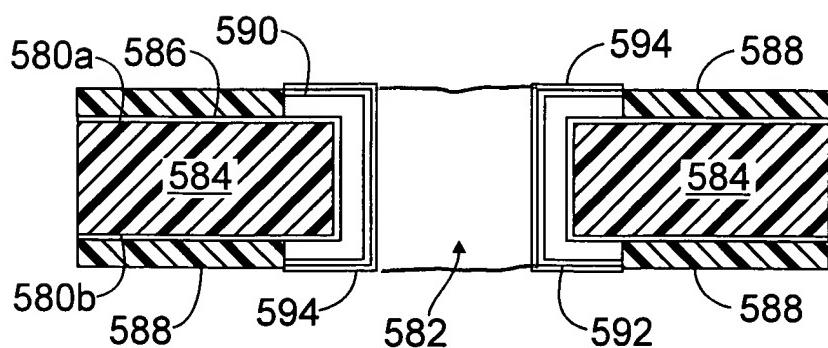

Red Line 9/22/58

Figure 6B

580

8/12

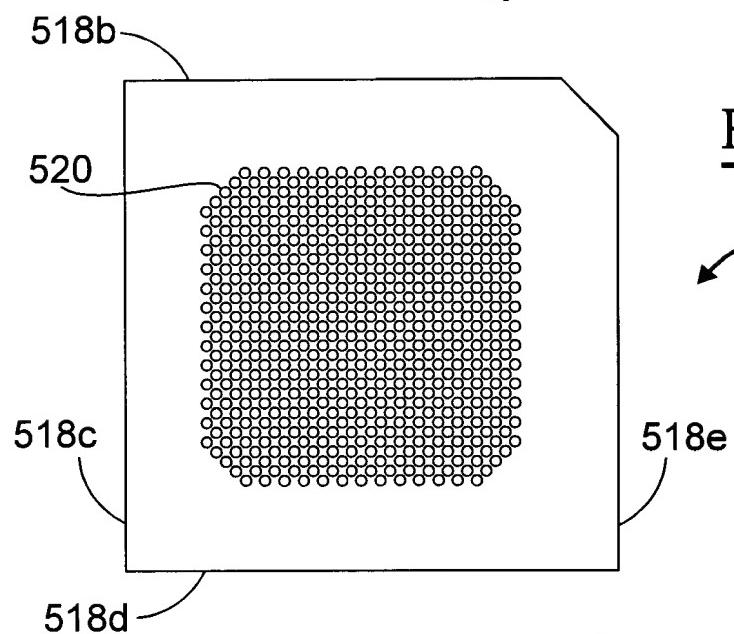


Figure 5C

518

Figure 6A

580

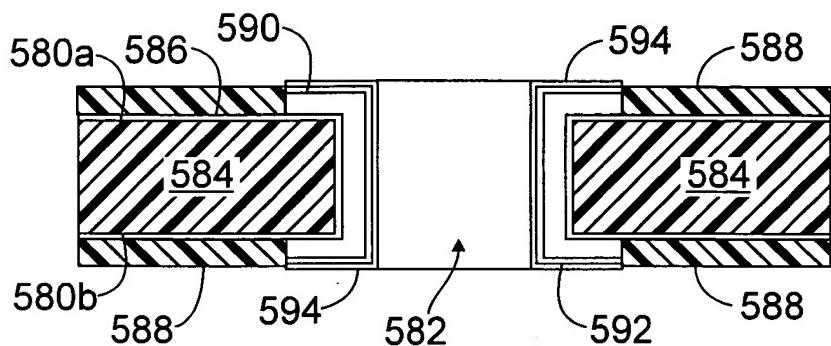
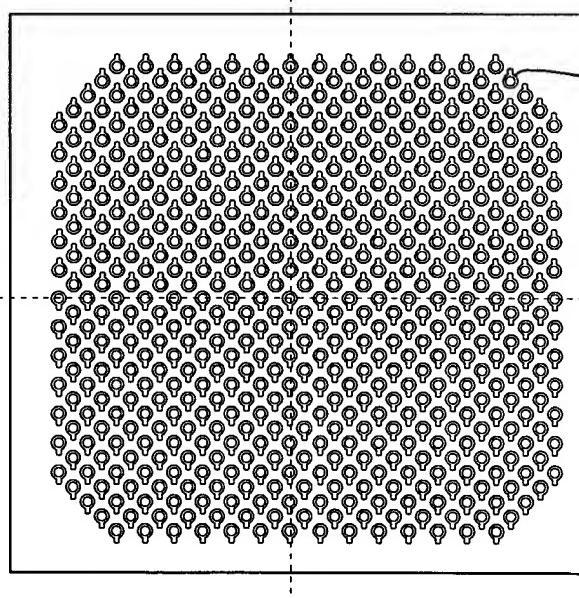


Figure 6B

580